
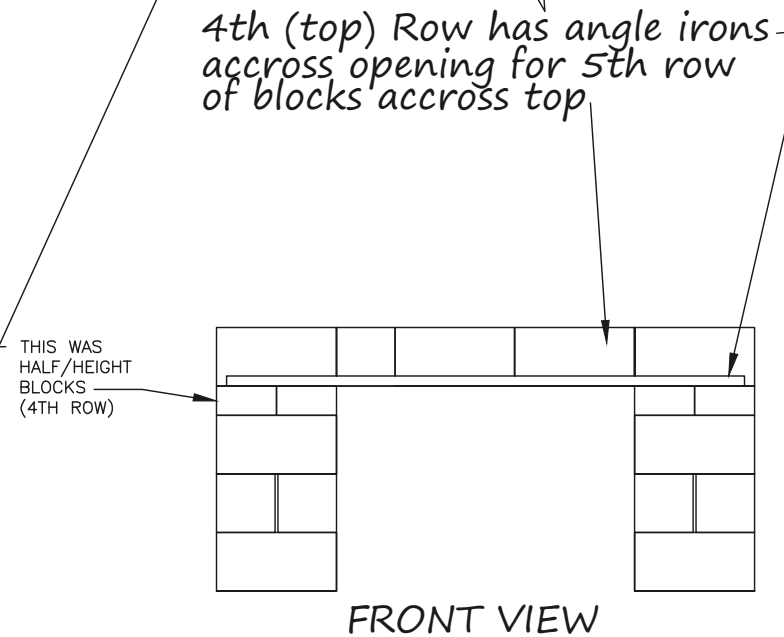


REMEMBER!

8"x16" CONCRETE BLOCK IS NOMINAL:
8" UNITS:
7 5/8" WIDE BY 15 5/8" LONG
THICKNESS IS 1-1/4"
RADIUS IS 5/8"

4.5 -16" BLOCKS WIDE
5 -16" BLOCKS DEEP

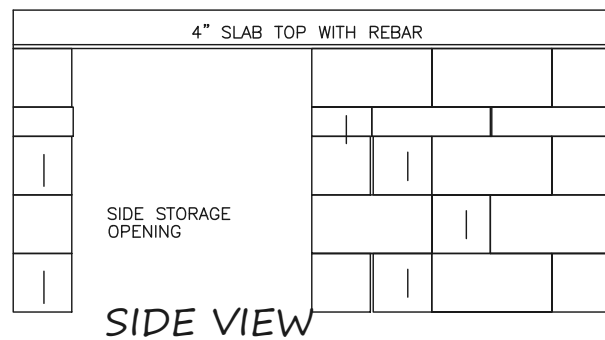

NOTES:

I PROBABLY COULD HAVE HAVE ONLY GONE 4 16" BLOCKS DEEP INSTEAD OF THE 4.5 BLOCKS I USED.

HOWEVER, THE COUNTER WOULD HAVE HAD TO CANTILEVER ANOTHER INCH OR 2.

A 39" OR 40" MAY HAVE FIT ON A BLOCK STAND 4 BY 4.5 BLOCKS DEEP. NOT SURE.

NOTE: THIS PLAN IS FOR REFERENCE ONLY, NOT FOR CONSTRUCTION.

AS-BUILT / BUILDING PLANS FOR DINO_PIZZA'S 42" OVEN STAND

SHEET P1 OF 2
WFO BLOCK STAND

1/2"=1'-0"